



AB BT 0089133 -344  
HUSKY 12-28-064-04W4  
HUSKY TUCKER LAKE 12-28 BITUMEN MMB  
IN-SITU OIL SANDS BATTERY  
LICENSEE: HUSKY OIL OPERATIONS LTD  
OPERATOR: HUSKY OIL OPERATIONS LTD

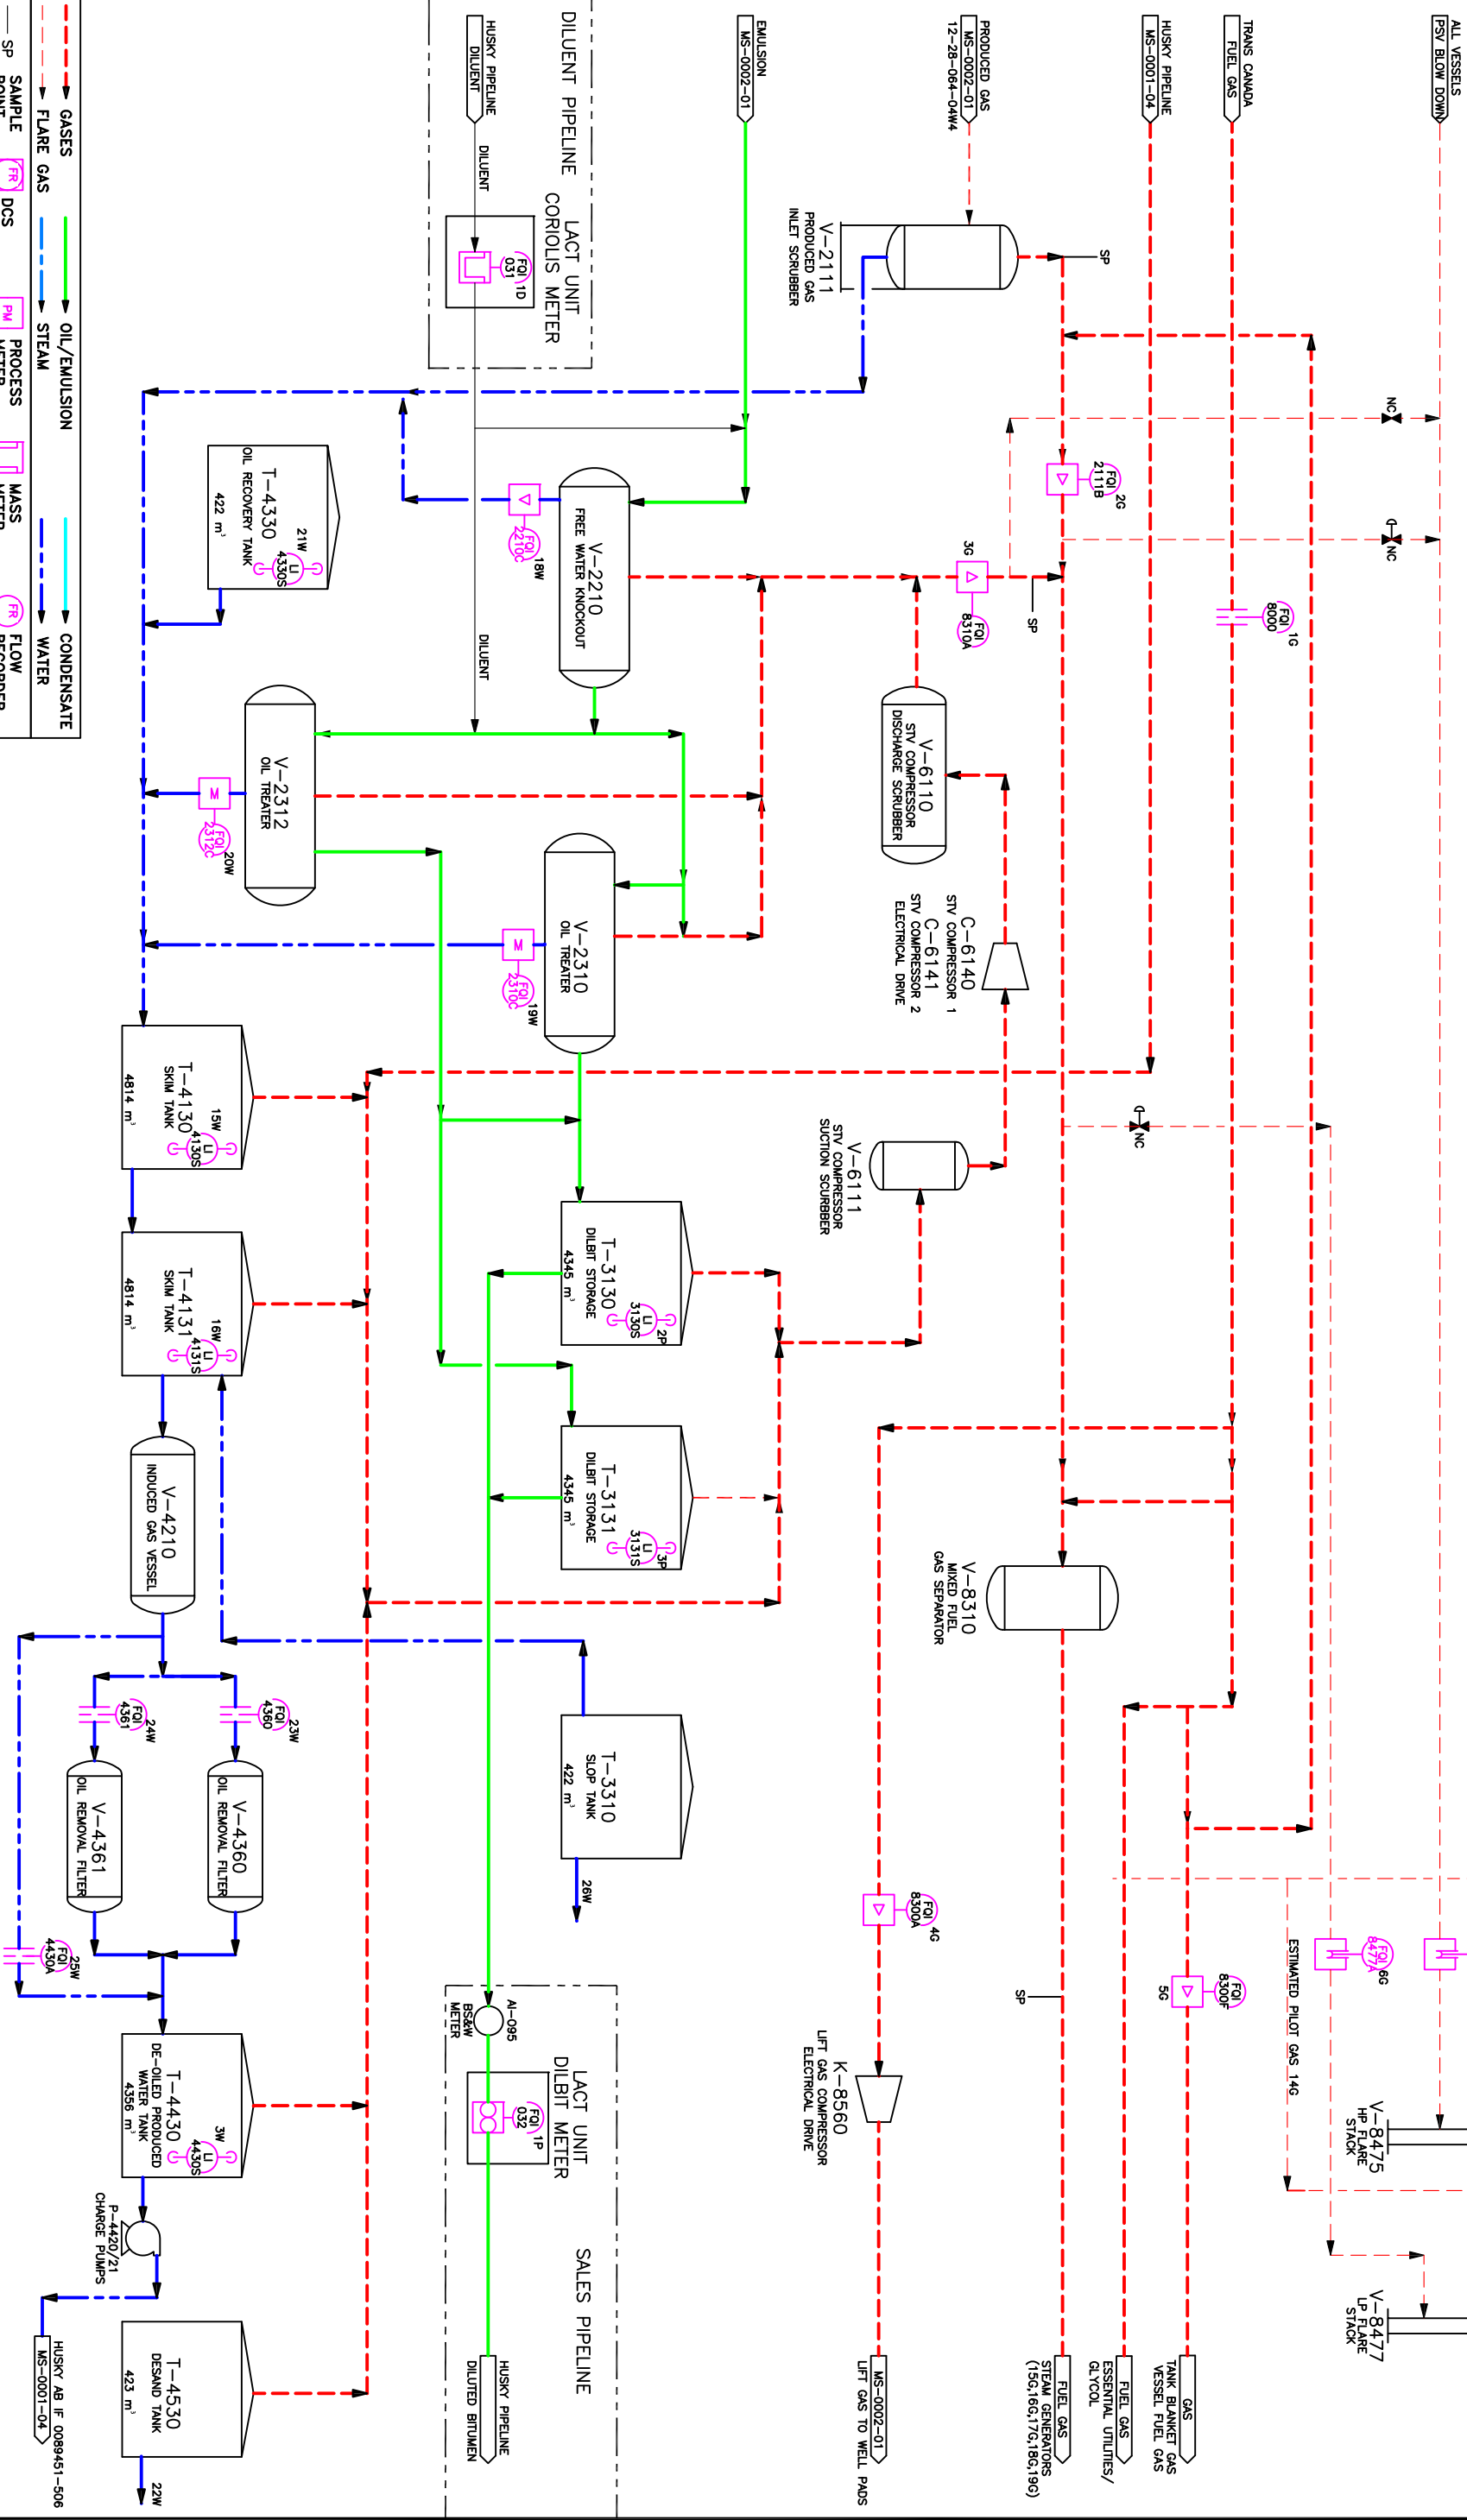

REF ID	NO	REFERENCE	DRAWING DESCRIPTION	NO	REVISION HISTORY	REV. AUTHOR	REV. DATE	ISSUED FOR	NO	CURRENT REVISION	ISSUED FOR
MS-0000-01		AREA OVERVIEW		1	CREATED FROM MARK UPS FROM ALLYSON HOLLAND	SK	2010/02/24	AS BUILT	2	NO UPDATES FOR THIS REVISION FROM ALLYSON HOLLAND	DOC DATE 2010/06/12
MS-0001-01 & 02		FACILITY DRAWING		2							DOC AUTHOR PC
MS-0002-01 TO 05		GATHERING SYSTEM		3							SCALE NTS
MS-0007-01		STEAM INJECTION SYSTEM		4							ALTERNATE IDENTIFIER
MS-0010-01		LOST UNIT		5							SURFACE LID 11/23-064-04M4
				6							DOCUMENT IDENTIFIER MS-0001-03
				7							
<div><div></div><div>TUCKER CENTRAL PLANT 12-28-064-04M4</div><div>FACILITY DRAWING MEASUREMENT SCHEMATIC</div></div>											