

PSV BLOW DOWN  
ALL VESSELS

TANK BLANKET GAS  
VESSEL FUEL GAS  
FUEL GAS

PRODUCED GAS  
MS-0002-0X  
12-28-064-04W4  
X=1, 2, 3, 4 & 6

EMULSION FROM  
MS-0002-0X  
12-28-064-04W4  
X=1, 2, 3, 4 & 6

AB PL 0075680-207  
HUSKY 03-12-050-01W4  
HUSKY CONDENSATE PIPELINE  
207-OIL PIPELINE  
LICENSEE: UNKNOWN  
OPERATOR: HUSKY OIL OPERATIONS LTD  
DILUENT FROM  
HUSKY 03-12-050-01W4


FACT UNIT  
CORIOLIS METER

FQI  
031

ENTRAINED GAS  
MS-0001-04  
12-28-064-04W4

AB IF 0089451-506  
HUSKY 12-28-064-04W4  
HUSKY TUCKER 12-28 INJECTION  
506-IN-SITU OIL SANDS INJECTION FACILITY  
LICENSEE: HUSKY OIL OPERATIONS LTD  
OPERATOR: HUSKY OIL OPERATIONS LTD

SERVICE WATER FROM  
MS-0001-04  
12-28-064-04W4

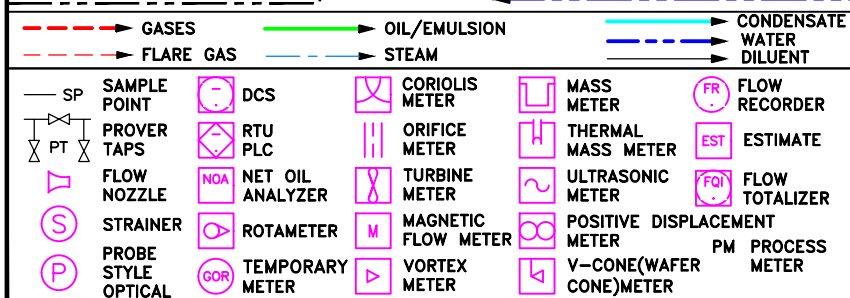

REF DWG NO	REFERENCE DRAWING DESCRIPTION	NO	REVISION HISTORY	REV AUTHOR	REV DATE	ISSUED FOR	NO	CURRENT REVISION	ISSUED FOR AS BUILT
MS-0000-01	AREA OVERVIEW	1	CREATED FROM MARK UPS FROM ALLYSON HADLAND	SK	2016/02/24	AS BUILT	6	UPDATED FROM MARK UPS FROM ANMOL BANSAL	DOC DATE 2018/08/07
MS-0001-04	FACILITY DRAWING	2	NO UPDATES FOR THIS REVISION FROM ALLYSON HADLAND	PC	2016/08/12	AS BUILT			DOC AUTHOR SK
MS-0002-01 TO 07	WELLS/FIELD	3	UPDATED PER MARK UPS FROM ALLYSON HADLAND	SK	2017/01/19	AS BUILT			SCALE NTS
MS-0007-01 TO 03	STEAM INJECTION SYSTEM	4	UPDATED FROM MARK UPS FROM ELSIE GUERRA	SK	2017/02/28	AS BUILT			ALTERNATE IDENTIFIER
MS-0004-01	WATER DISPOSAL SYSTEM	5	UPDATED FROM MARK UPS FROM ELSIE GUERRA	SK	2018/03/20	AS BUILT			
MS-0010-01	LACT UNIT	6							
		7							

**TUCKER CENTRAL PLANT 12-28-064-04W4**

FACILITY DRAWING  
MEASUREMENT SCHEMATIC

**SURFACE LSD**  
12-28-064-04W4

**DOCUMENT IDENTIFIER**  
MS-0001-03

**CAD DRAWING: DO NOT CHANGE MANUALLY**