



AB BT 0089133 -344
HUSKY 12-28-064-04W4
HUSKY TUCKER LAKE 12-28 BITUMEN MWB
344-IN SITU OIL SANDS BATTERY
LICENSEE: HUSKY OIL OPERATIONS LTD
OPERATOR: HUSKY OIL OPERATIONS LTD

LIFT GAS FROM
MS-0001-03
12-28-064-04W4

WELL PAD A							
WELL NAME	UWI	LSD	LIC/OPER	DETAIL	STATUS	FUEL	LIFT
A1S	105/05-32-064-04W4/00	09-32-064-04W4	HUSKY	OIL 2A	SAGD	E	ESP
A2S	110/12-32-064-04W4/00	09-32-064-04W4	HUSKY	OIL 2A	SAGD	E	ESP
A3S	108/12-32-064-04W4/00	09-32-064-04W4	HUSKY	OIL 2A	SAGD	E	ESP
A4S	109/12-32-064-04W4/00	09-32-064-04W4	HUSKY	OIL 2A	SAGD	E	ESP
A5S	107/12-32-064-04W4/00	09-32-064-04W4	HUSKY	OIL 2A	SAGD	E	ESP
A6S	103/13-32-064-04W4/00	16-32-064-04W4	HUSKY	OIL 2A	SAGD	E	ESP
A7S	107/13-32-064-04W4/00	16-32-064-04W4	HUSKY	OIL 2A	SAGD	E	ESP
A8S	108/13-32-064-04W4/00	16-32-064-04W4	HUSKY	OIL 2A	SAGD	E	ESP


WELL PAD B							
WELL NAME	UWI	LSD	LIC/OPER	DETAIL	STATUS	FUEL	LIFT
B3P	103/04-32-064-04W4/00	01-32-064-04W4	HUSKY	OIL 2A	SAGD	E	ESP
B4P	104/04-32-064-04W4/00	01-32-064-04W4	HUSKY	OIL 2A	SAGD	E	ESP
B2P	106/04-32-064-04W4/00	01-32-064-04W4	HUSKY	OIL 2A	SAGD	E	ESP
B1P	110/04-32-064-04W4/00	01-32-064-04W4	HUSKY	OIL 2A	SAGD	E	ESP
B8P	103/05-32-064-04W4/00	08-32-064-04W4	HUSKY	OIL 2A	SAGD	E	ESP
B7P	104/05-32-064-04W4/00	08-32-064-04W4	HUSKY	OIL 2A	SAGD	E	ESP
B5P	106/05-32-064-04W4/00	01-32-064-04W4	HUSKY	OIL 2A	SAGD	E	ESP
B6P	107/05-32-064-04W4/00	01-32-064-04W4	HUSKY	OIL 2A	SAGD	E	ESP
B9P	104/15-32-064-04W4/00	08-32-064-04W4	HUSKY	OIL 2A	SAGD	E	ESP
B10S	106/16-32-064-04W4/00	08-32-064-04W4	HUSKY	OIL 2A	SAGD	E	ESP
B11S	107/16-32-064-04W4/00	08-32-064-04W4	HUSKY	OIL 2A	SAGD	E	ESP
B12S	109/16-32-064-04W4/00	08-32-064-04W4	HUSKY	OIL 2A	SAGD	E	ESP

WELL PAD C							
WELL NAME	UWI	LSD	LIC/OPER	DETAIL	STATUS	FUEL	LIFT
C4S	108/12-29-064-04W4/00	09-29-064-04W4	HUSKY	OIL 2A	SAGD	E	ESP
C1S	100/12-29-064-04W4/00	09-29-064-04W4	HUSKY	OIL 2A	SAGD	E	ESP
C2S	104/12-29-064-04W4/00	09-29-064-04W4	HUSKY	OIL 2A	SAGD	E	ESP
C3S	107/12-29-064-04W4/00	09-29-064-04W4	HUSKY	OIL 2A	SAGD	E	ESP
C5S	108/13-29-064-04W4/00	09-29-064-04W4	HUSKY	OIL 2A	SAGD	E	ESP
C6S	106/13-29-064-04W4/00	16-29-064-04W4	HUSKY	OIL 2A	SAGD	E	ESP
C7S	107/13-29-064-04W4/00	16-29-064-04W4	HUSKY	OIL 2A	SAGD	E	ESP
C8S	109/13-29-064-04W4/00	16-29-064-04W4	HUSKY	OIL 2A	SAGD	E	ESP
C9S	105/07-32-064-04W4/00	16-29-064-04W4	HUSKY	OIL 2A	SAGD	E	ESP

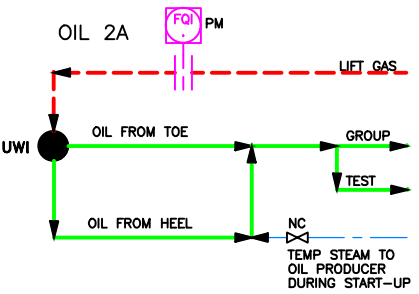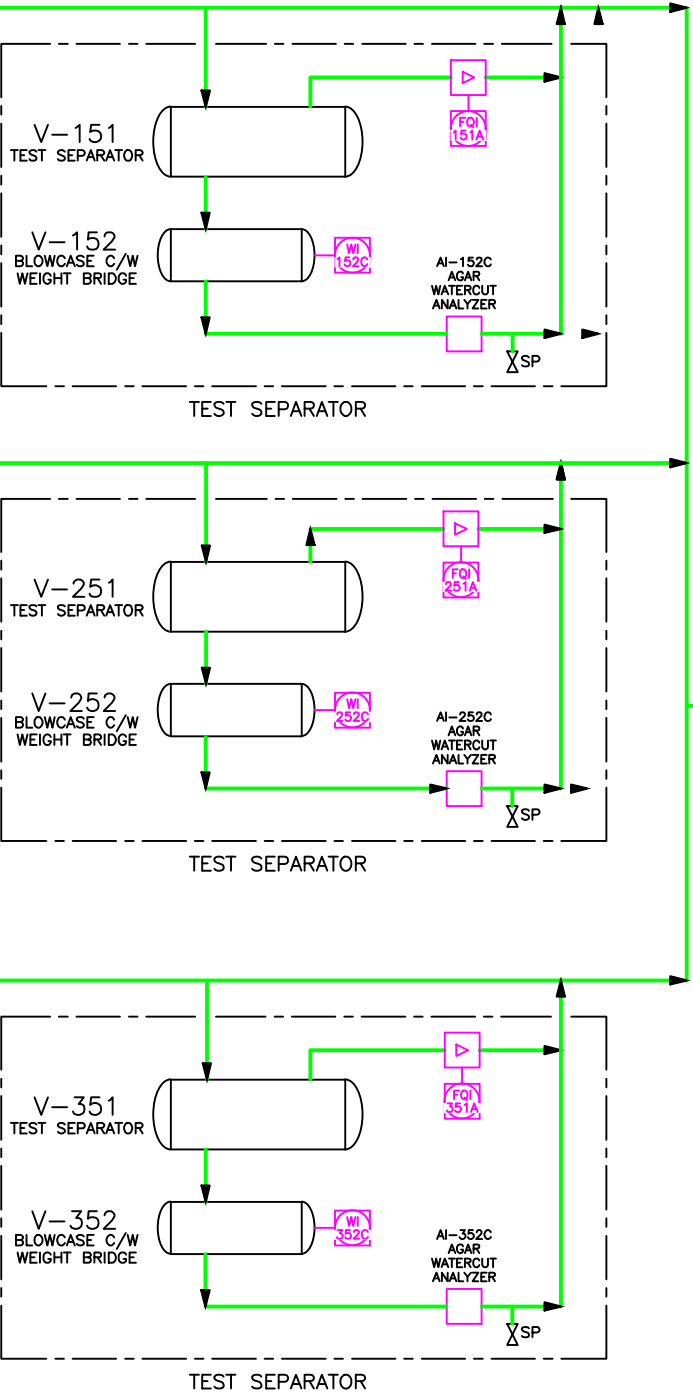

PRODUCED GAS TO
MS-0001-03
12-28-064-04W4
EMULSION TO
MS-0001-03
12-28-064-04W4

01-32-064-04W4
CENTRAL FIELD FACILITY

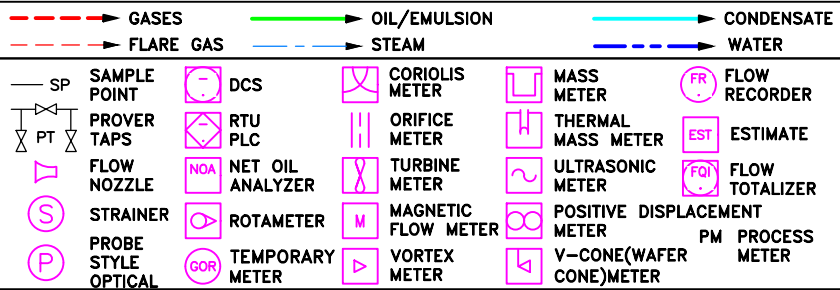

REF DWG NO	REFERENCE DRAWING DESCRIPTION	NO	REVISION HISTORY	REV AUTHOR	REV DATE	ISSUED FOR	NO	CURRENT REVISION	ISSUED FOR	AS BUILT
MS-0000-01	AREA OVERVIEW	8	UPDATED FROM MARK UPS FROM ALLYSON HADLAND	SK	2016/02/24	AS BUILT	11	UPDATED FROM MARK UPS FROM ELSIE GUERRA	DOC DATE	2018/03/20
MS-0001-03 & 04	FACILITY DRAWING	9	NO UPDATES FOR THIS REVISION FROM ALLYSON HADLAND	PC	2016/08/12	AS BUILT			DOC AUTHOR	SK
MS-0002-02 TO 07	WELLS/FIELD	10	UPDATED FROM MARK UPS FROM ALLYSON HADLAND	SK	2017/01/19	AS BUILT			SCALE	NTS
MS-0007-01 TO 03	STEAM INJECTION SYSTEM	4	UPDATED PER MARK-UPS FROM ALLYSON HADLAND	DMM	2013/06/07	AS BUILT			ALTERNATE IDENTIFIER	
MS-0004-01	WATER DISPOSAL SYSTEM	5	UPDATED PER MARK UPS FROM ALLYSON HADLAND	SK	2014/08/20	AS BUILT				
MS-0010-01	LACT UNIT	6	UPDATED FROM MARK UPS SUPPLIED BY ALLYSON HADLAND	BRM	2015/02/24	AS BUILT				
		7	NO UPDATES FOR THIS REVISION FROM ALLYSON HADLAND	BRM	2015/10/29	AS BUILT				

Husky Oil Operations Limited

TUCKER CENTRAL PLANT 12-28-064-04W4
A, B & C PADS
WELLS/FIELD
MEASUREMENT SCHEMATIC

SURFACE LSD	12-28-064-04W4
DOCUMENT IDENTIFIER	MS-0002-01

CAD DRAWING: DO NOT CHANGE MANUALLY