

AB BT 0089133 -344
HUSKY 12-28-064-04W4
HUSKY TUCKER LAKE 12-28 BITUMEN MWB
344-IN SITU OIL SANDS BATTERY
LICENSEE: HUSKY OIL OPERATIONS LTD
OPERATOR: HUSKY OIL OPERATIONS LTD



LIFT GAS FROM
MS-0001-03
12-28-064-04W4

WELL PAD C							
WELL NAME	UWI	LSD	LIC/OPER	DETAIL	STATUS	FUEL	LIFT
C20P	104/07-28-064-04W4/00	09-29-064-04W4	HUSKY	OIL 2A	SAGD	E	ESP
C16P	100/10-28-064-04W4/00	09-29-064-04W4	HUSKY	OIL 2A	SAGD	E	ESP
C18P	102/10-28-064-04W4/00	09-29-064-04W4	HUSKY	OIL 2A	SAGD	E	ESP
C17P	104/10-28-064-04W4/00	09-29-064-04W4	HUSKY	OIL 2A	SAGD	E	ESP
C19P	106/10-28-064-04W4/00	09-29-064-04W4	HUSKY	OIL 2A	SAGD	E	ESP
C14P	103/15-28-064-04W4/00	16-29-064-04W4	HUSKY	OIL 2A	SAGD	E	ESP
C13P	105/15-28-064-04W4/00	16-29-064-04W4	HUSKY	OIL 2A	SAGD	E	ESP
C15P	107/15-28-064-04W4/00	16-29-064-04W4	HUSKY	OIL 2A	SAGD	E	ESP

WELL PAD A							
WELL NAME	UWI	LSD	LIC/OPER	DETAIL	STATUS	FUEL	LIFT
A20P	113/12-32-064-04W4/00	09-32-064-04W4	HUSKY	OIL 2A(ii)	SAGD	E	ESP
A18P	114/12-32-064-04W4/00	09-32-064-04W4	HUSKY	OIL 2A(ii)	SAGD	E	ESP
A17P	116/12-32-064-04W4/00	09-32-064-04W4	HUSKY	OIL 2A(ii)	SAGD	E	ESP
A19P	119/12-32-064-04W4/00	09-32-064-04W4	HUSKY	OIL 2A(ii)	SAGD	E	ESP

WELL PAD A							
WELL NAME	UWI	LSD	LIC/OPER	DETAIL	STATUS	FUEL	LIFT
A16P	124/12-32-064-04W4/00	09-32-064-04W4	HUSKY	OIL 2A(i)	SAGD	E	ESP
A15P	125/12-32-064-04W4/00	09-32-064-04W4	HUSKY	OIL 2A(i)	SAGD	E	ESP
A9P	109/13-32-064-04W4/00	16-32-064-04W4	HUSKY	OIL 2A(i)	SAGD	E	ESP
A12P	112/13-32-064-04W4/00	16-32-064-04W4	HUSKY	OIL 2A(i)	SAGD	E	ESP
A11P	113/13-32-064-04W4/00	16-32-064-04W4	HUSKY	OIL 2A(i)	SAGD	E	ESP
A10P	115/13-32-064-04W4/00	16-32-064-04W4	HUSKY	OIL 2A(i)	SAGD	E	ESP
A13P	117/13-32-064-04W4/00	09-32-064-04W4	HUSKY	OIL 2A(i)	SAGD	E	ESP
A14P	107/15-28-064-04W4/00	09-32-064-04W4	HUSKY	OIL 2A(i)	SAGD	E	ESP

WELL PAD A							
WELL NAME	UWI	LSD	LIC/OPER	DETAIL	STATUS	FUEL	LIFT
A23P	113/05-32-064-04W4/00	09-32-064-04W4	HUSKY	OIL 2A(ii)	SAGD	E	ESP
A24P	114/05-32-064-04W4/00	09-32-064-04W4	HUSKY	OIL 2A(ii)	SAGD	E	ESP
A22P	120/12-32-064-04W4/00	09-32-064-04W4	HUSKY	OIL 2A(ii)	SAGD	E	ESP
A21P	122/12-32-064-04W4/00	09-32-064-04W4	HUSKY	OIL 2A(ii)	SAGD	E	ESP

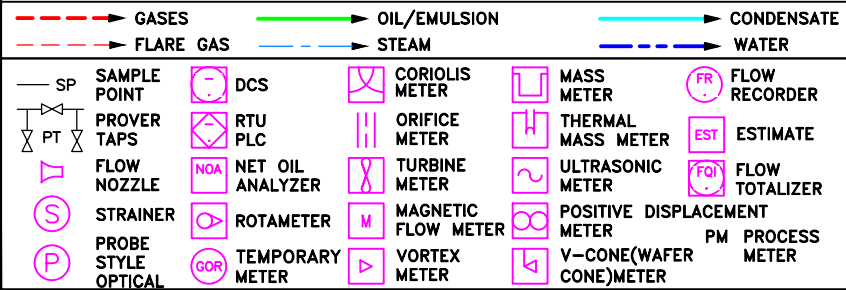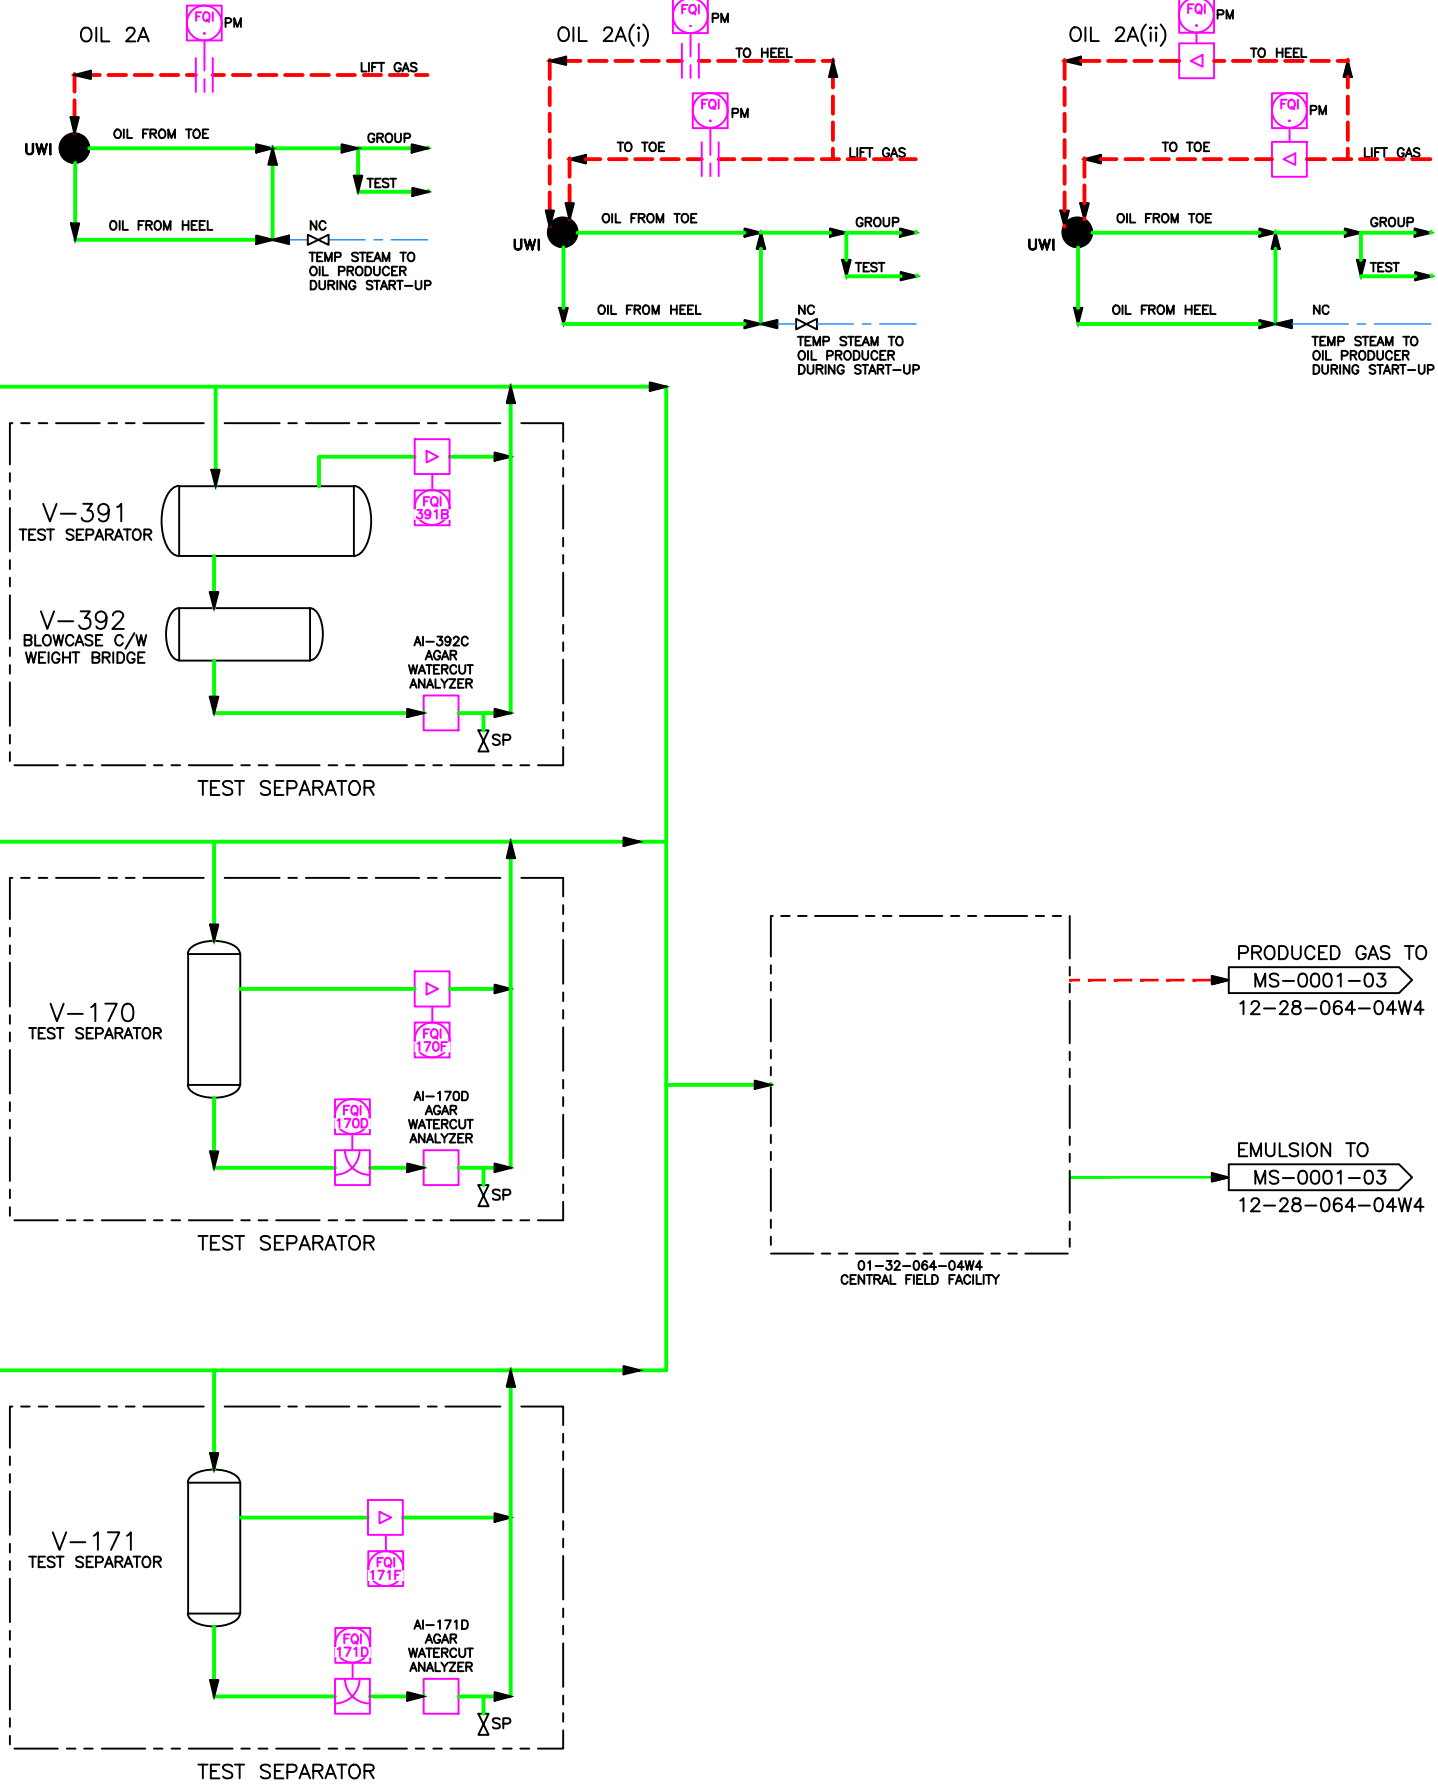

REF DWG NO	REFERENCE DRAWING DESCRIPTION	NO	REVISION HISTORY	REV AUTHOR	REV DATE	ISSUED FOR	NO	CURRENT REVISION	ISSUED FOR AS BUILT
MS-0000-01	AREA OVERVIEW	8	NO UPDATES TO THIS REVISION FROM ALLYSON HADLAND	PC	2018/08/12	AS BUILT	9	UPDATED FROM MARK UPS FROM ELSIE GUERRA	DOC DATE 2018/03/20
MS-0001-03 & 04	FACILITY DRAWING	2	UPDATED PER MARK UPS FROM TIAN QIU	PJC	2012/08/03	AS BUILT			DOC AUTHOR SK
MS-0002-01, 03 TO 07	WELLS/FIELD	3	UPDATED PER MARK-UPS FROM ALLYSON HADLAND	DMM	2013/06/07	AS BUILT			SCALE NTS
MS-0007-01 TO 03	STEAM INJECTION SYSTEM	4	UPDATED PER MARK UPS FROM ALLYSON HADLAND	SK	2014/08/20	AS BUILT			ALTERNATE IDENTIFIER
MS-0004-01	WATER DISPOSAL SYSTEM	5	UPDATED FROM MARK UPS SUPPLIED BY ALLYSON HADLAND	BRM	2015/02/24	AS BUILT			
MS-0010-01	LACT UNIT	6	NO UPDATES FOR THIS REVISION FROM ALLYSON HADLAND	BRM	2015/10/29	AS BUILT			
		7	UPDATED FROM MARK UPS FROM ALLYSON HADLAND	SK	2016/02/24	AS BUILT			

TUCKER CENTRAL PLANT 12-28-064-04W4
A AND C PADS
WELLS/FIELD
MEASUREMENT SCHEMATIC

SURFACE LSD
12-28-064-04W4
DOCUMENT IDENTIFIER
MS-0002-02