


AB BT 0089133 -344
HUSKY 12-28-064-04W4
HUSKY TUCKER LAKE 12-28 BITUMEN MWB
344-IN SITU OIL SANDS BATTERY
LICENSEE: HUSKY OIL OPERATIONS LTD
OPERATOR: HUSKY OIL OPERATIONS LTD



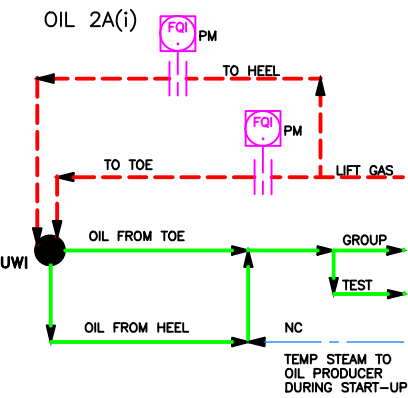


LIFT GAS FROM
MS-0001-03
12-28-064-04W4

WELL PAD B13P WELLS							
WELL NAME	UWI	LSD	LIC/OPER	DETAIL	STATUS	FUEL	LIFT
B9EP	111/16-32-064-04W4/00	01-32-064-04W4	HUSKY	OIL 2A(i)	SAGD	E	ESP

WELL PAD B14P WELLS							
WELL NAME	UWI	LSD	LIC/OPER	DETAIL	STATUS	FUEL	LIFT
B10EP	113/16-32-064-04W4/00	01-32-064-04W4	HUSKY	OIL 2A(i)	SAGD	E	ESP

WELL PAD B15P WELLS							
WELL NAME	UWI	LSD	LIC/OPER	DETAIL	STATUS	FUEL	LIFT
B11EP	115/16-32-064-04W4/00	01-32-064-04W4	HUSKY	OIL 2A(i)	SAGD	E	ESP

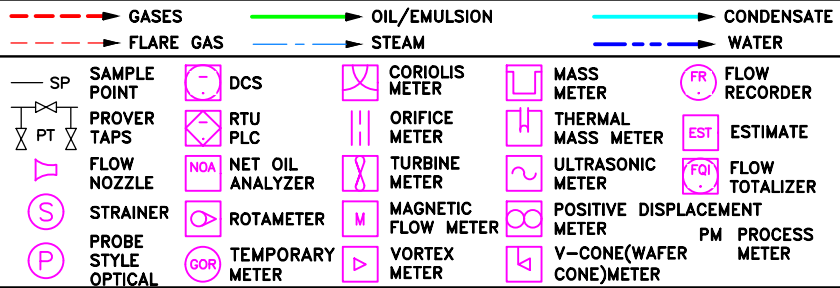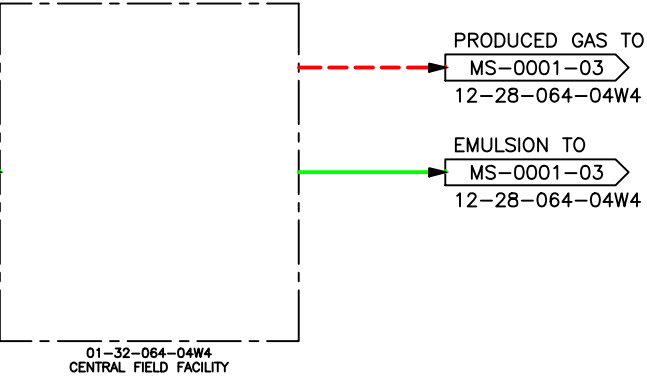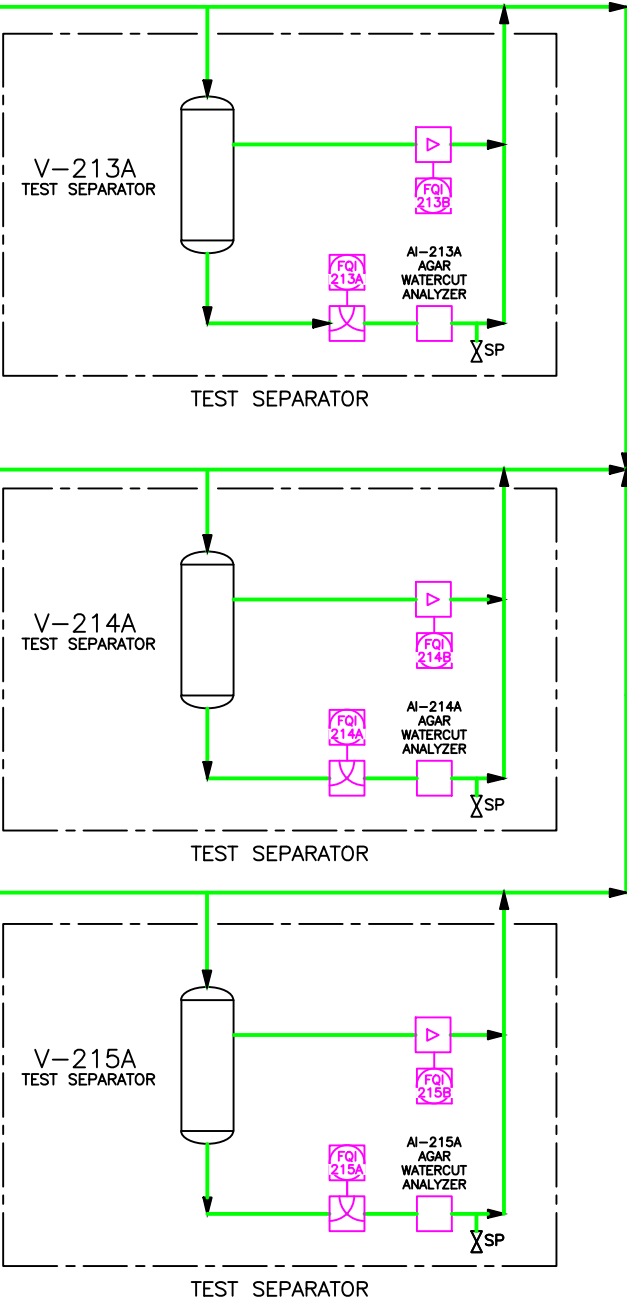

REF DWG NO	REFERENCE DRAWING DESCRIPTION	NO	REVISION HISTORY	REV AUTHOR	REV DATE	ISSUED FOR	NO	CURRENT REVISION	ISSUED FOR	AS BUILT
MS-0000-01	AREA OVERVIEW	1	UPDATED PER MARK UPS SUPPLIED BY TIAN QIU	WDA	2012/02/01	AS BUILT	8	UPDATED FROM MARK UPS FROM ELSIE GUERRA	DOC DATE	2018/03/20
MS-0001-03 & 04	FACILITY DRAWING	2	UPDATED PER MARK-UPS FROM ALLYSON HADLAND	DMM	2013/06/07	AS BUILT			DOC AUTHOR	SK
MS-0002-01,02, 04 TO 07	WELLS/FIELD	3	UPDATED PER MARK UPS FROM ALLYSON HADLAND	SK	2014/08/20	AS BUILT			SCALE	NTS
MS-0007-01 TO 03	STEAM INJECTION SYSTEM	4	UPDATED FROM MARK UPS SUPPLIED BY ALLYSON HADLAND	BRM	2015/02/24	AS BUILT			ALTERNATE IDENTIFIER	
MS-0004-01	WATER DISPOSAL SYSTEM	5	NO UPDATES FOR THIS REVISION FROM ALLYSON HADLAND	BRM	2015/10/29	AS BUILT			SURFACE LSD	12-28-064-04W4
MS-0010-01	LACT UNIT	6	UPDATED FROM MARK UPS FROM ALLYSON HADLAND	BRM	2016/02/24	AS BUILT			DOCUMENT IDENTIFIER	MS-0002-03
		7	NO UPDATES FOR THIS REVISION FROM ALLYSON HADLAND	PC	2016/08/12	AS BUILT				

Husky Oil Operations Limited

TUCKER CENTRAL PLANT 12-28-064-04W4
B PADS
WELLS/FIELD
MEASUREMENT SCHEMATIC

CAD DRAWING: DO NOT CHANGE MANUALLY