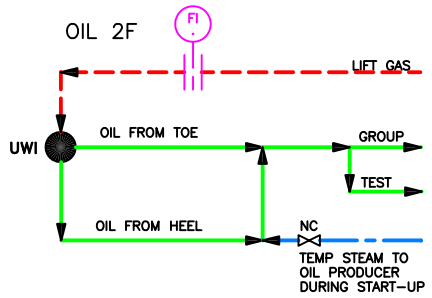

AB BT 0089133 — WELL PAD GRAND RAPIDS

WELL NAME	UWI	LSD	LIC/OPER	DETAIL	STATUS	FUEL	TOE	HEEL
GA05P	105/15-32-064-04W4/00	07-32-064-04W4	HUSKY	OIL 2F	PRODUCING	–	FIC-505N	FIC-505P
GA06P	106/15-32-064-04W4/00	07-32-064-04W4	HUSKY	OIL 2F	PRODUCING	–	FIC-506N	FIC-506P
GA01P	119/16-32-064-04W4/00	07-32-064-04W4	HUSKY	OIL 2F	PRODUCING	–	FIC-501N	FIC-501P
GA02P	120/16-32-064-04W4/00	07-32-064-04W4	HUSKY	OIL 2F	PRODUCING	–	FIC-502N	FIC-502P
GA03P	121/16-32-064-04W4/00	07-32-064-04W4	HUSKY	OIL 2F	PRODUCING	–	FIC-503N	FIC-503P
GA04P	122/16-32-064-04W4/00	07-32-064-04W4	HUSKY	OIL 2F	PRODUCING	–	FIC-504N	FIC-504P

AB BT 0089133 — WELL PAD D EAST

WELL NAME	UWI	LSD	LIC/OPER	DETAIL	STATUS	FUEL	TOE	HEEL
D24P	111/07-28-064-04W4/00	07-28-064-04W4	HUSKY	OIL 2F	PRODUCING	–	FIC-424N	FIC-424P
D25P	112/07-28-064-04W4/00	07-28-064-04W4	HUSKY	OIL 2F	PRODUCING	–	FIC-425N	FIC-425P
D26P	113/07-28-064-04W4/00	07-28-064-04W4	HUSKY	OIL 2F	PRODUCING	–	FIC-426N	FIC-426P
D27P	114/07-28-064-04W4/00	07-28-064-04W4	HUSKY	OIL 2F	PRODUCING	–	FIC-427N	FIC-427P
D28P	115/07-28-064-04W4/00	07-28-064-04W4	HUSKY	OIL 2F	PRODUCING	–	FIC-428N	FIC-428P
D29P	116/07-28-064-04W4/00	07-28-064-04W4	HUSKY	OIL 2F	PRODUCING	–	FIC-429N	FIC-429P
D30P	104/02-28-064-04W4/00	02-28-064-04W4	HUSKY	OIL 2F	PRODUCING	–	FIC-430N	FIC-430P
D31P	105/02-28-064-04W4/00	02-28-064-04W4	HUSKY	OIL 2F	PRODUCING	–	FIC-431N	FIC-431P
D32P	106/02-28-064-04W4/00	02-28-064-04W4	HUSKY	OIL 2F	PRODUCING	–	FIC-432N	FIC-432P
D33P	107/02-28-064-04W4/00	02-28-064-04W4	HUSKY	OIL 2F	PRODUCING	–	FIC-433N	FIC-433P

AB BT 0089133 — WELL PAD D EAST

WELL NAME	UWI	LSD	LIC/OPER	DETAIL	STATUS	FUEL	TOE	HEEL
D34P	112/02-28-064-04W4/00	02-28-064-04W4	HUSKY	OIL 2F	PRODUCING	–	FIC-434N	FIC-434P
D35P	111/02-28-064-04W4/00	02-28-064-04W4	HUSKY	OIL 2F	PRODUCING	–	FIC-435N	FIC-435P
D36P	115/02-28-064-04W4/00	02-28-064-04W4	HUSKY	OIL 2F	PRODUCING	–	FIC-436N	FIC-436P
D37P	108/02-28-064-04W4/00	02-28-064-04W4	HUSKY	OIL 2F	PRODUCING	–	FIC-437N	FIC-437P
D38P	109/02-28-064-04W4/00	02-28-064-04W4	HUSKY	OIL 2F	PRODUCING	–	FIC-438N	FIC-438P

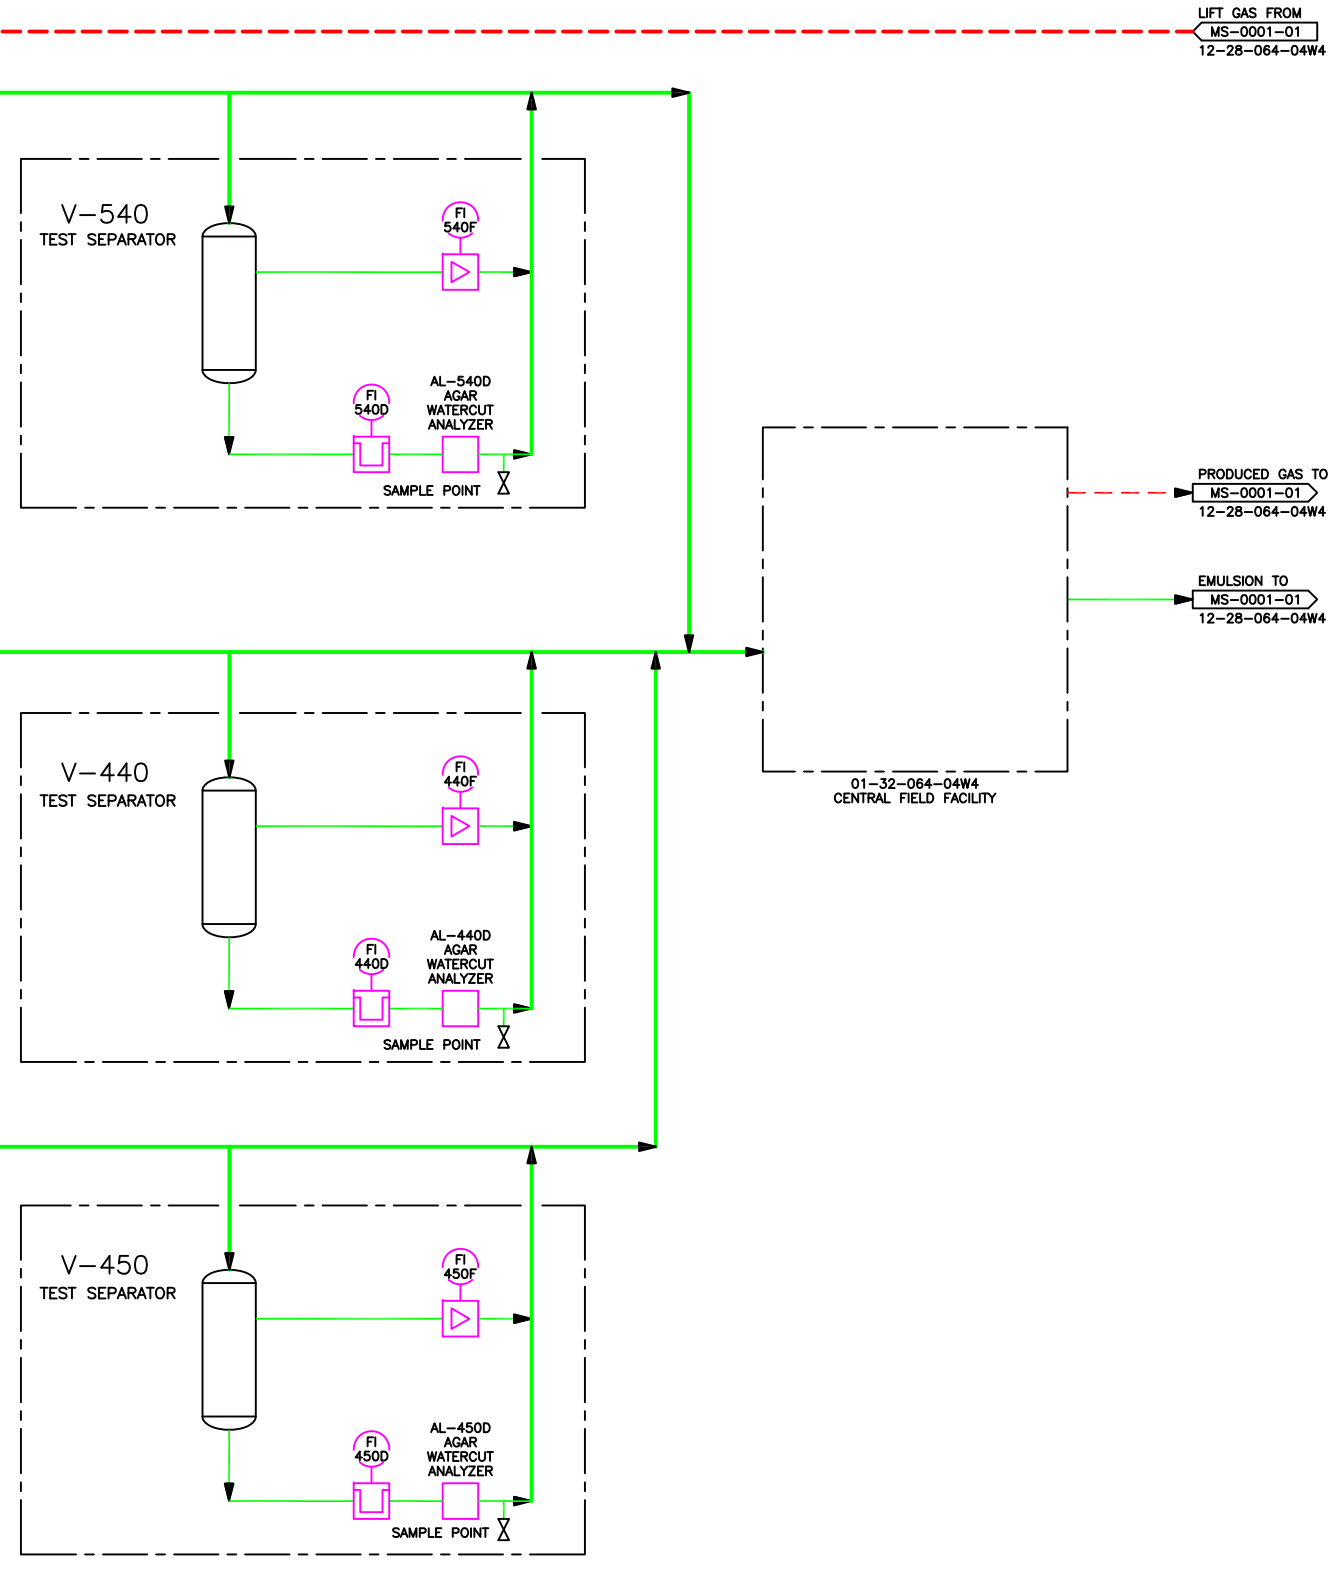

GASES — OIL/EMULSION — CONDENSATE
FLARE GAS — STEAM — WATER

SAMPLE POINT (SP) · PROVER TAPS (PT) · FLOW NOZZLE · STRAINER (S) · PROBE STYLE OPTICAL (P)
DCS (FR) · RTU PLC · NET OIL ANALYZER (NOA) · ROTAMETER · TEMPORARY METER (GOR)
PROCESS METER (PM) · ORIFICE METER · TURBINE METER · MAGNETIC FLOW METER (M) · VORTEX METER
MASS METER · THERMAL MASS METER (H) · ULTRASONIC METER · POSITIVE DISPLACEMENT METER · V-CONE (WAFER CONE) METER
FLOW RECORDER (FR) · FLOW TOTALIZER (FQI)

REF DWG NO	REFERENCE DRAWING DESCRIPTION	NO	REVISION HISTORY	REV AUTHOR	REV DATE	ISSUED FOR
MS-0000-01	AREA OVERVIEW	8	UPDATED PER MARK UPS FROM ALLYSON HADLAND	SK	2016/02/24	AS BUILT
MS-0001-01 & 02	FACILITY DRAWING	2	UPDATED PER MARK-UPS FROM ALLYSON HADLAND	DMM	2013/06/07	AS BUILT
MS-0002-01,02,03&05	GATHERING SYSTEM	3	UPDATED PER MARK UPS FROM ALLYSON HADLAND	SK	2014/08/20	AS BUILT
MS-0007-01	STEAM INJECTION SYSTEM	4	UPDATED FROM MARK UPS SUPPLIED BY ALLYSON HADLAND	BRM	2015/02/24	AS BUILT
MS-0010-01	LACT UNIT	5	UPDATED FROM MARK UPS SUPPLIED BY PETE CURRAN	BRM	2015/07/06	AS BUILT
		6	UPDATED FROM MARK UPS SUPPLIED BY PETE CURRAN	BRM	2015/07/27	AS BUILT
		7	NO UPDATES FOR THIS REVISION FROM ALLYSON HADLAND	BRM	2015/10/29	AS BUILT

22206

NO	CURRENT REVISION	ISSUED FOR AS BUILT
9	NO UPDATES FOR THIS REVISION FROM ALLYSON HADLAND	DOC DATE 2016/08/12
		DOC AUTHOR PC
		SCALE NTS
		ALTERNATE IDENTIFIER
		SURFACE LSD 12-28-064-04W4
		DOCUMENT IDENTIFIER MS-0002-04

Husky Oil Operations Limited

TUCKER CENTRAL PLANT 12-28-064-04W4

GATHERING SYSTEM-GRAND RAPIDS & D PADS
MEASUREMENT SCHEMATIC

CAD DRAWING: DO NOT CHANGE MANUALLY